


DWG/5762/15/5762-00.DWG 9/8/75

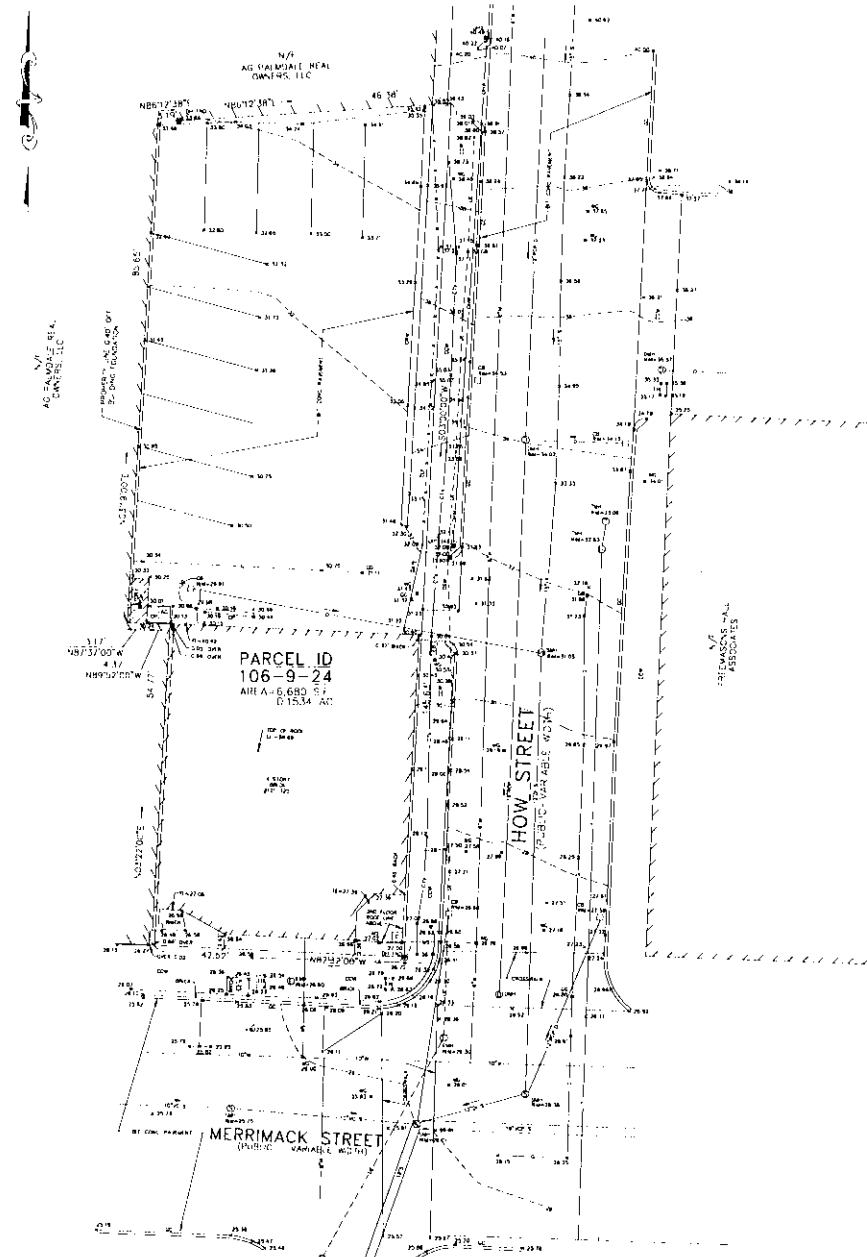

NOTES

1. SEE CITY OF HAVERHILL PARCEL ID #DB 9-24, DEED BOOK #1123 PAGE #254 AND PLAN #293 OF 1977 RECORD FOR SITE, NORTH BASED ON THAT PLAN.
2. TOPOGRAPHIC DATA NAVD83 ESTABLISHED BY RIK GPS.
3. UTILITIES FROM FIELD SURVEY AND RECORD PLANS.

LEGEND

- D-I HOLE
- D-M-I DRAIN MANHOLE
- S-M-I SEWER MANHOLE
- T-M-I TELEPHONE MANHOLE
- CATCH BASIN
- ELEC BOX
- G-M GAS METER
- W-G WATER GATE
- S-GN
- U-P UTILITY POLE
- C-T-UP HYDRANT
- ✕ 12.12 SPOT ELEVATION
- 37 ELEVATION CONTOUR
- S SEWER PIPELINE
- D DRAIN PIPELINE
- W WATER PIPELINE
- G GAS PIPELINE
- TELEPHONE CONDUIT
- CIV CABLE TELEVISION CONDUIT
- JE UNDERGROUND ELECTRIC CONDUIT
- OW OVERHEAD WIRE
- X X C-1 CHAIN LINK FENCE
- ROP REINFORCED CONCRETE
- VC VENEERED CLAY
- J DIGESTIBLE BRICK
- GC GRANITE CURB
- 11 THREE SIDED ELEVATION
- N/N NEW OR FORMER
- FND FOUND
- CRW CONCRETE RETAINING WALL
- HEI CONCRETE
- C-W CEMENT CONCRETE WALK
- HW BITUMINOUS CONCRETE WALK


PLAN OF LAND 119-125 MERRIMACK STREET IN HAVERHILL, MASSACHUSETTS

PREPARED FOR
**DAVINCI MINI APARTMENTS
C/O JONEY PEREZ**

55 AVON STREET
LAWRENCE, MASSACHUSETTS 01840

DATE SEPTEMBER 15, 2005

SCALE 1"=10'

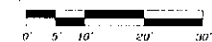

MERRIMACK ENGINEERING SERVICES
66 PARK STREET
ANDOVER, MASSACHUSETTS 01810
PHONE: (978) 475-3555 FAX: (978) 475-1440
EMAIL: MERRENG@AOL.COM